


UNIT 100

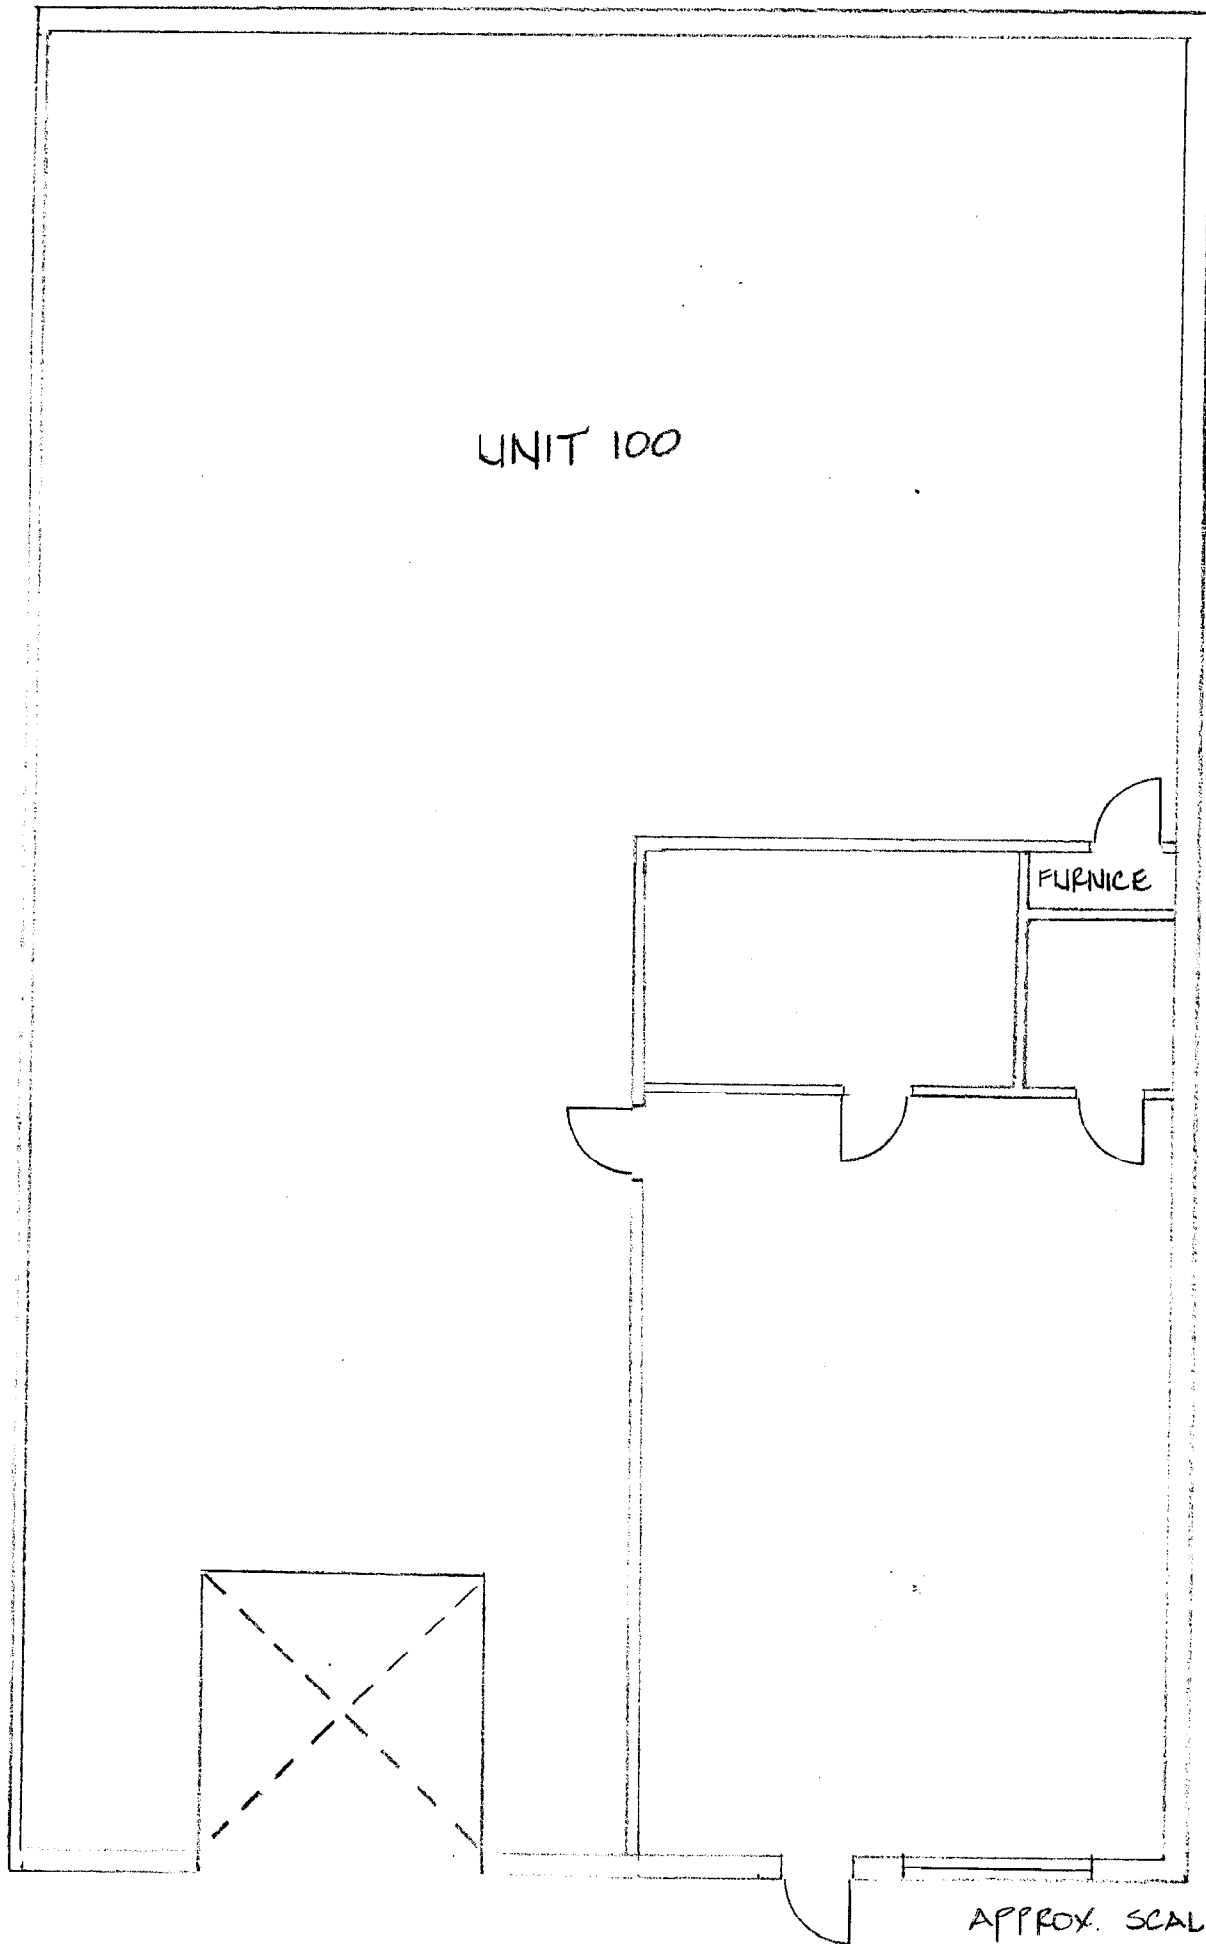

APPROX. SCALE 1/8" = 1'