


1090 H
1,046 SF

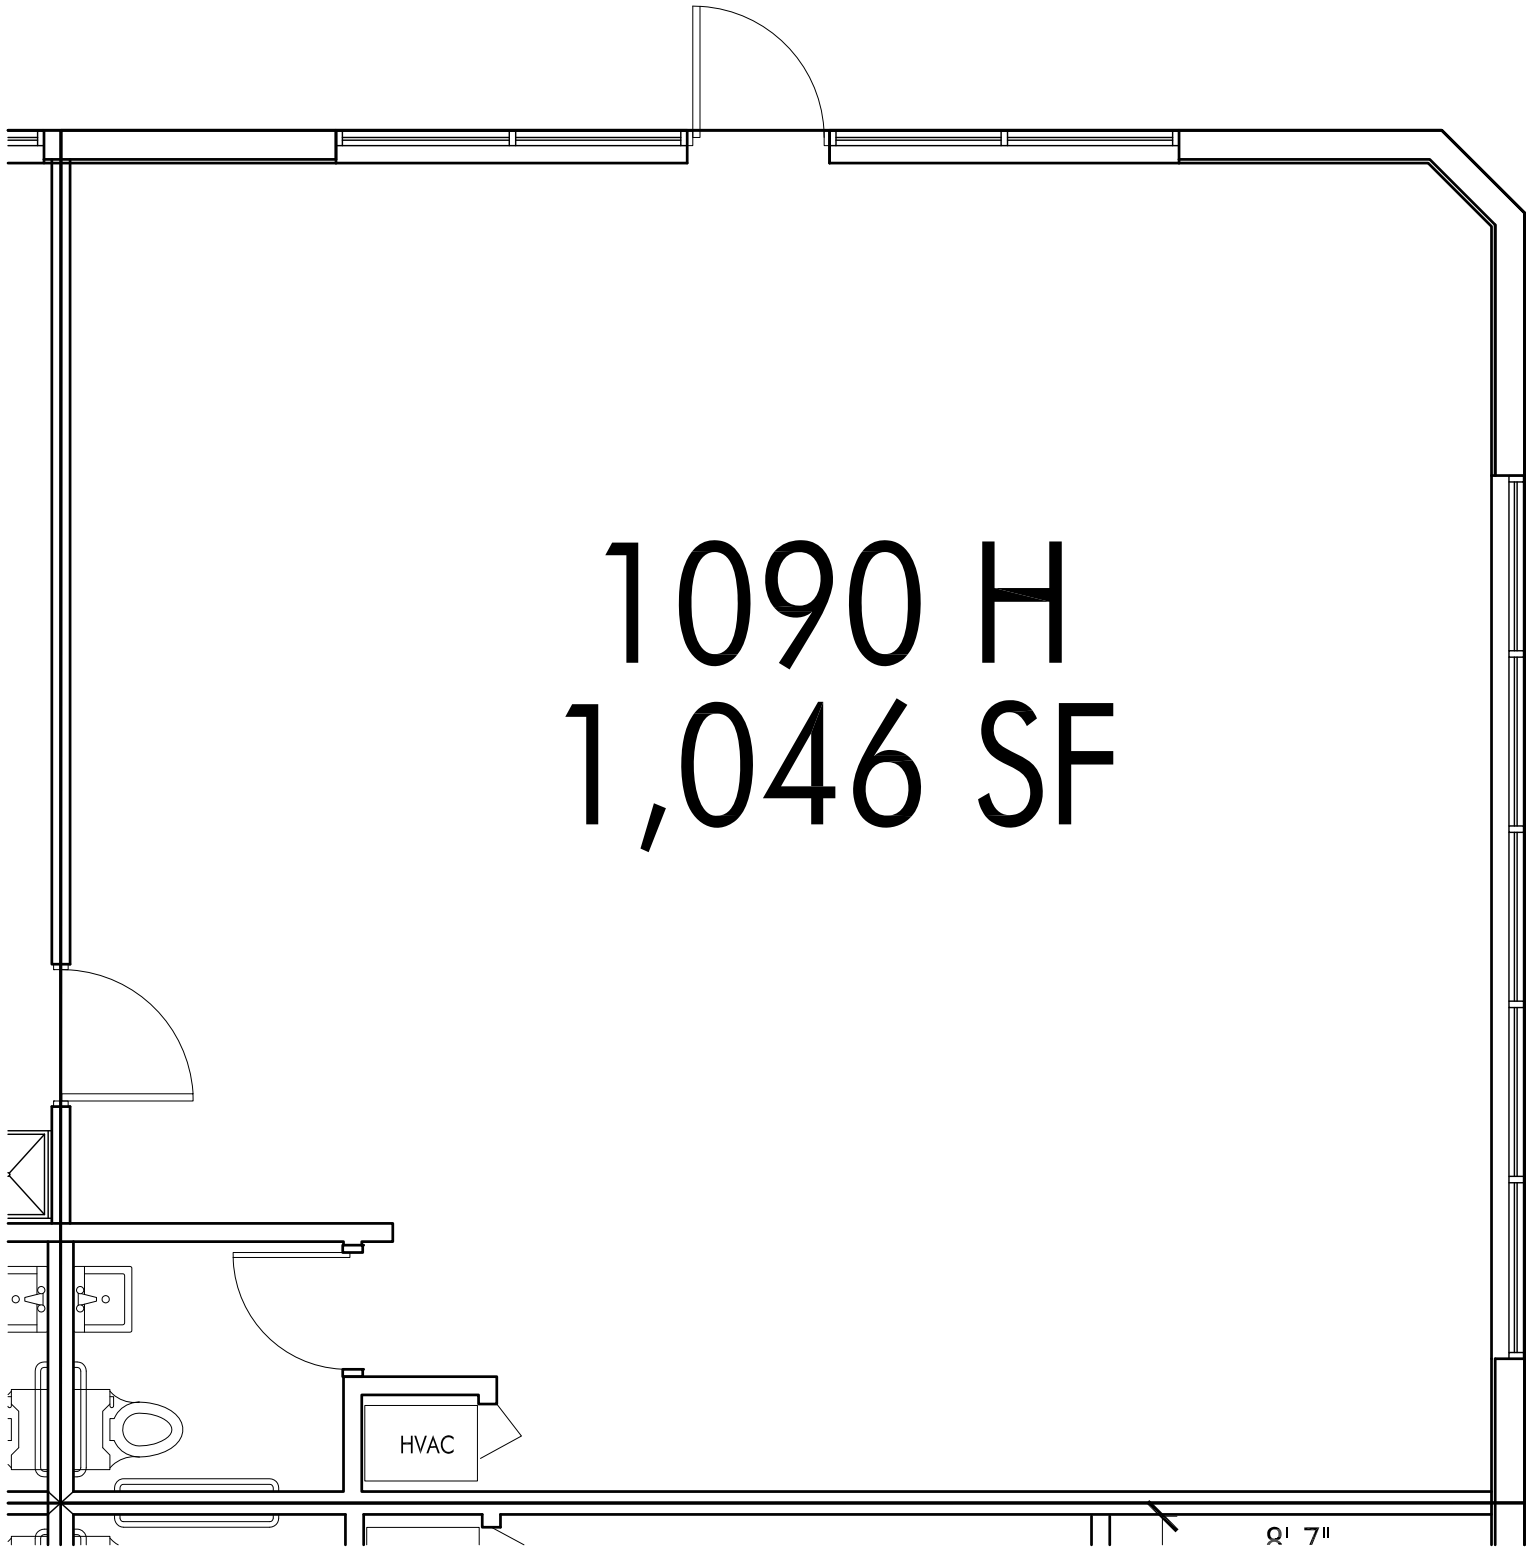

2' 7"